


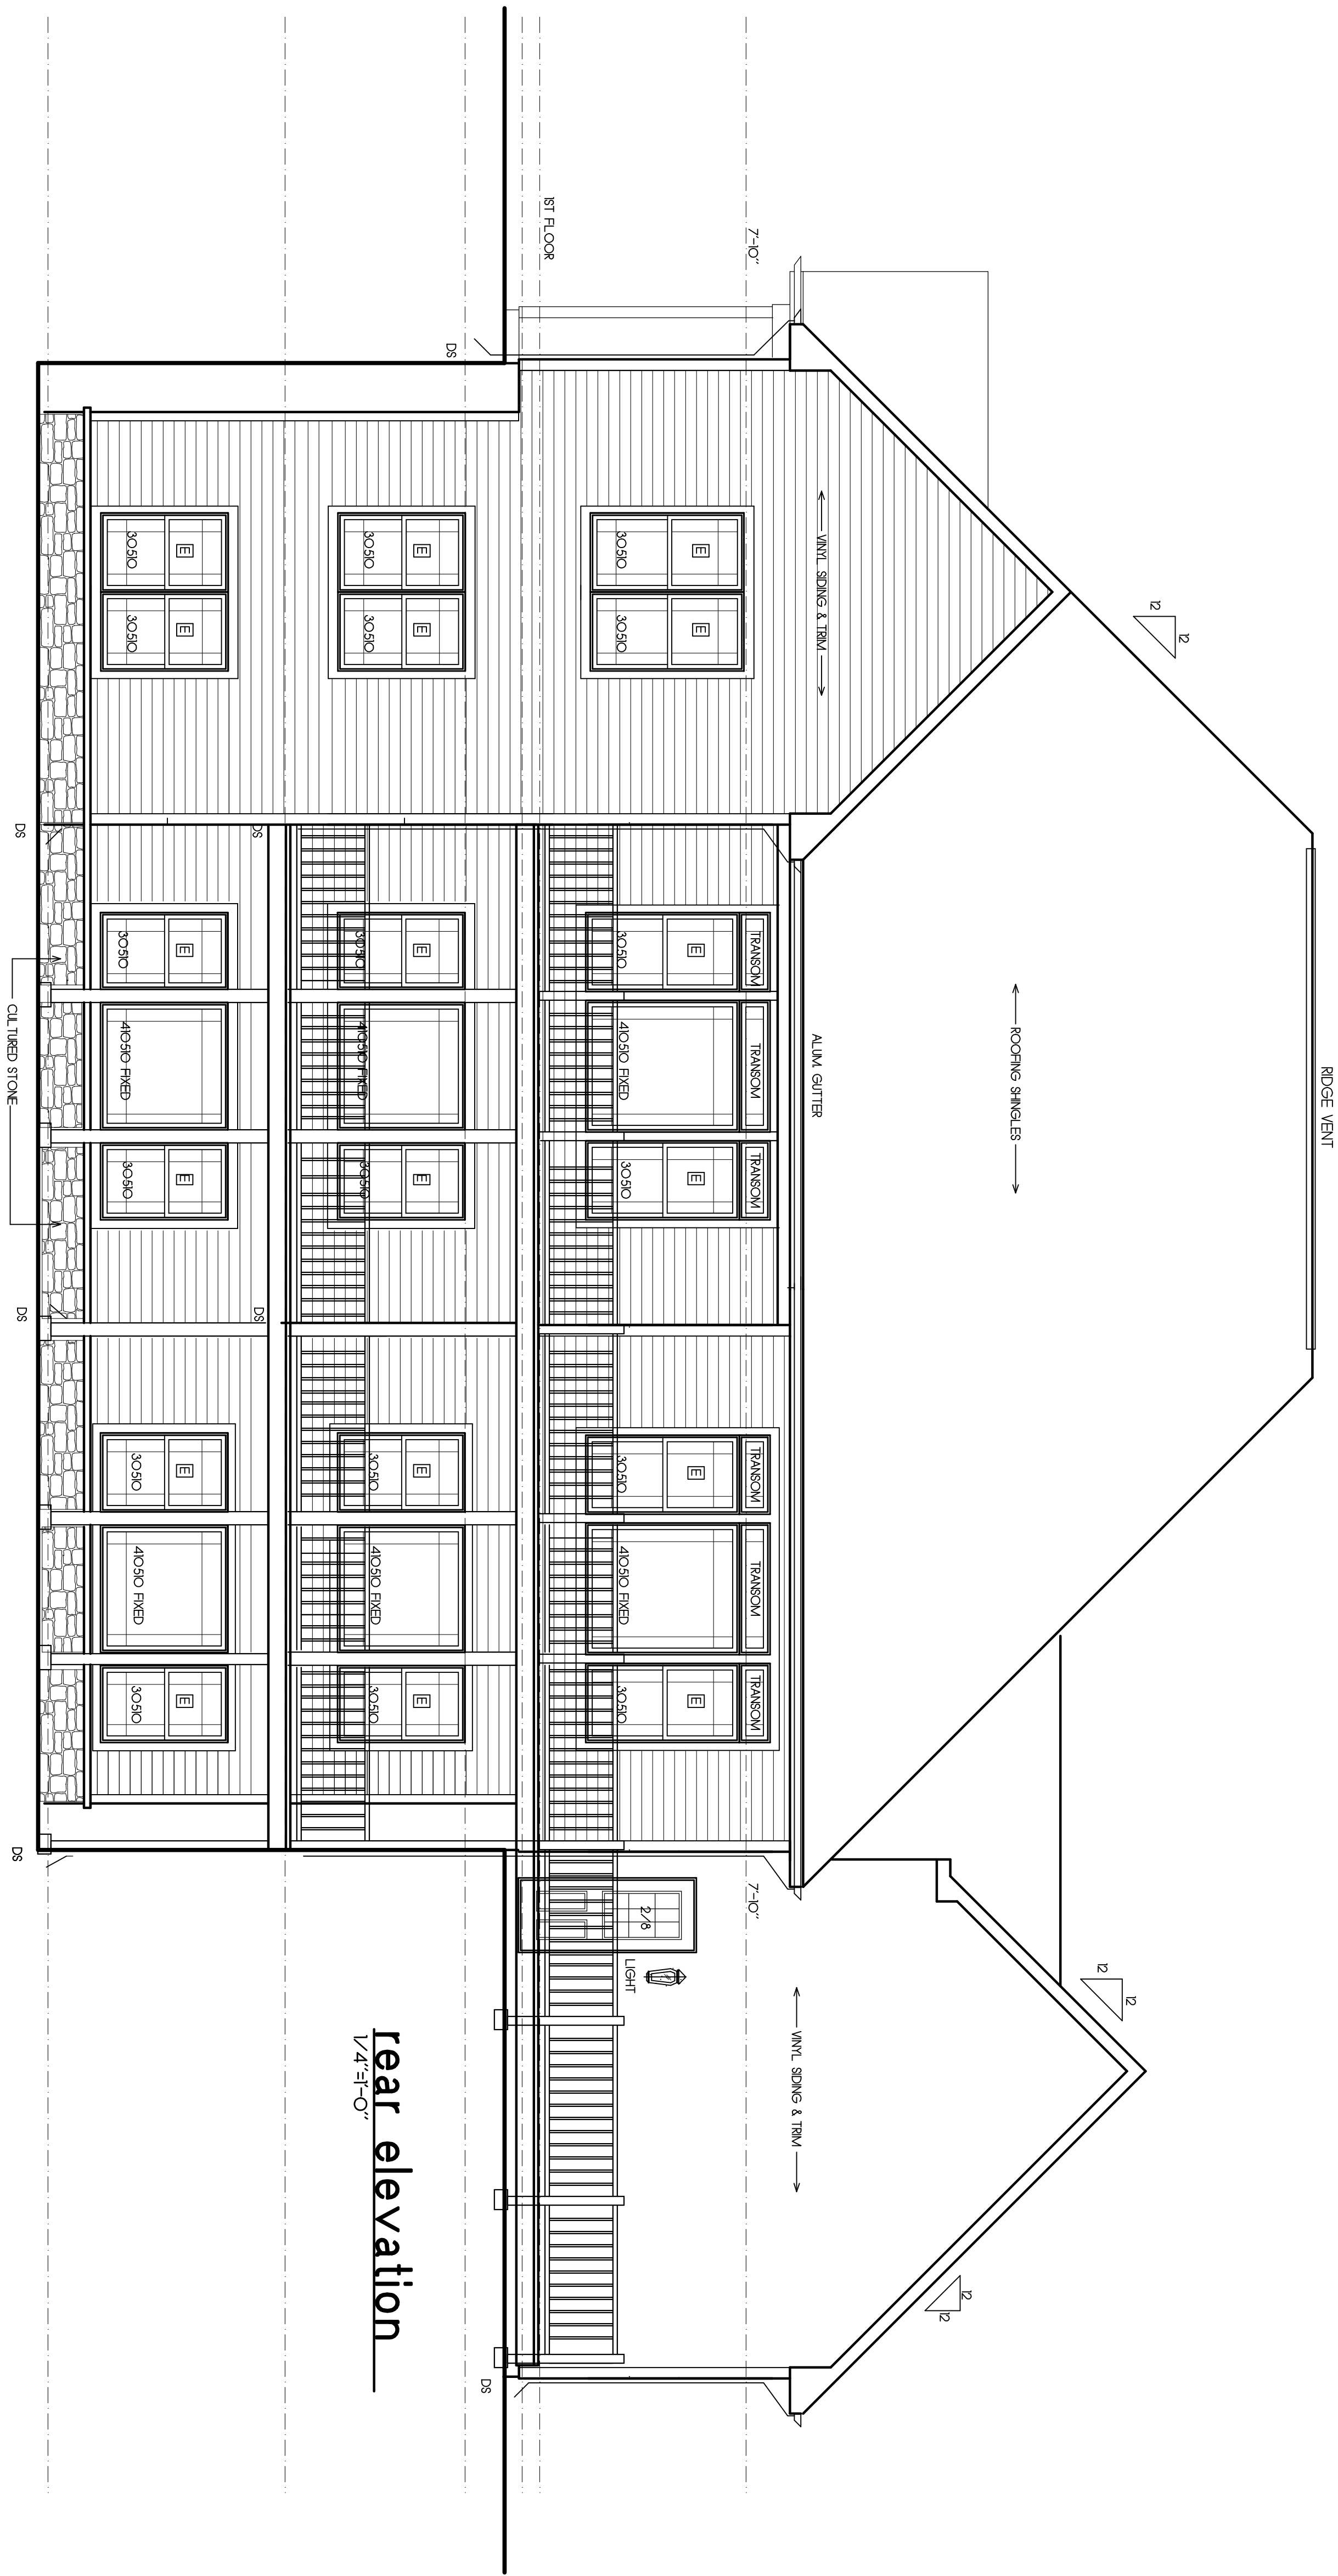

ALA architects

255 EAST AVENUE ROCHESTER, NEW YORK 14604
(585) 512-2099 ALAARC@FRONTIERNET.NET

PROPOSED RESIDENCE
FOR
MR. & MRS. PIERCE

WEST LAKE ROAD CANANDAIGUA, NEW YORK

REVISIONS		
No.	DATE	DESCRIPTION

JOB NO.15054

A-4

JUL. Y 25, 2015