


" Unauthorized alteration or addition
to a map bearing a Licensed
Professional Engineer's or
Professional Land Surveyor's seal in
any way is a Violation of Section 7209"


" Copyright 2022" Venezia &
Associates. All rights reserved
unauthorized duplication is a
violation of all applicable laws"



This is to certify that I am a Licensed Land Surveyor and
that this plan was completed on 12/19/2022 from notes of an
instrument survey performed on 12/14/2022

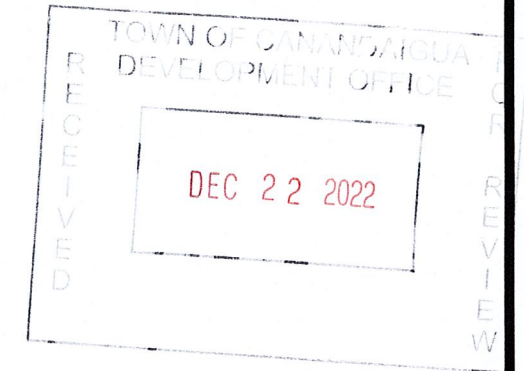

T.M. # 97.04-2- 57.1
File# Lot 57 ASB
Scale: 1"= 40'

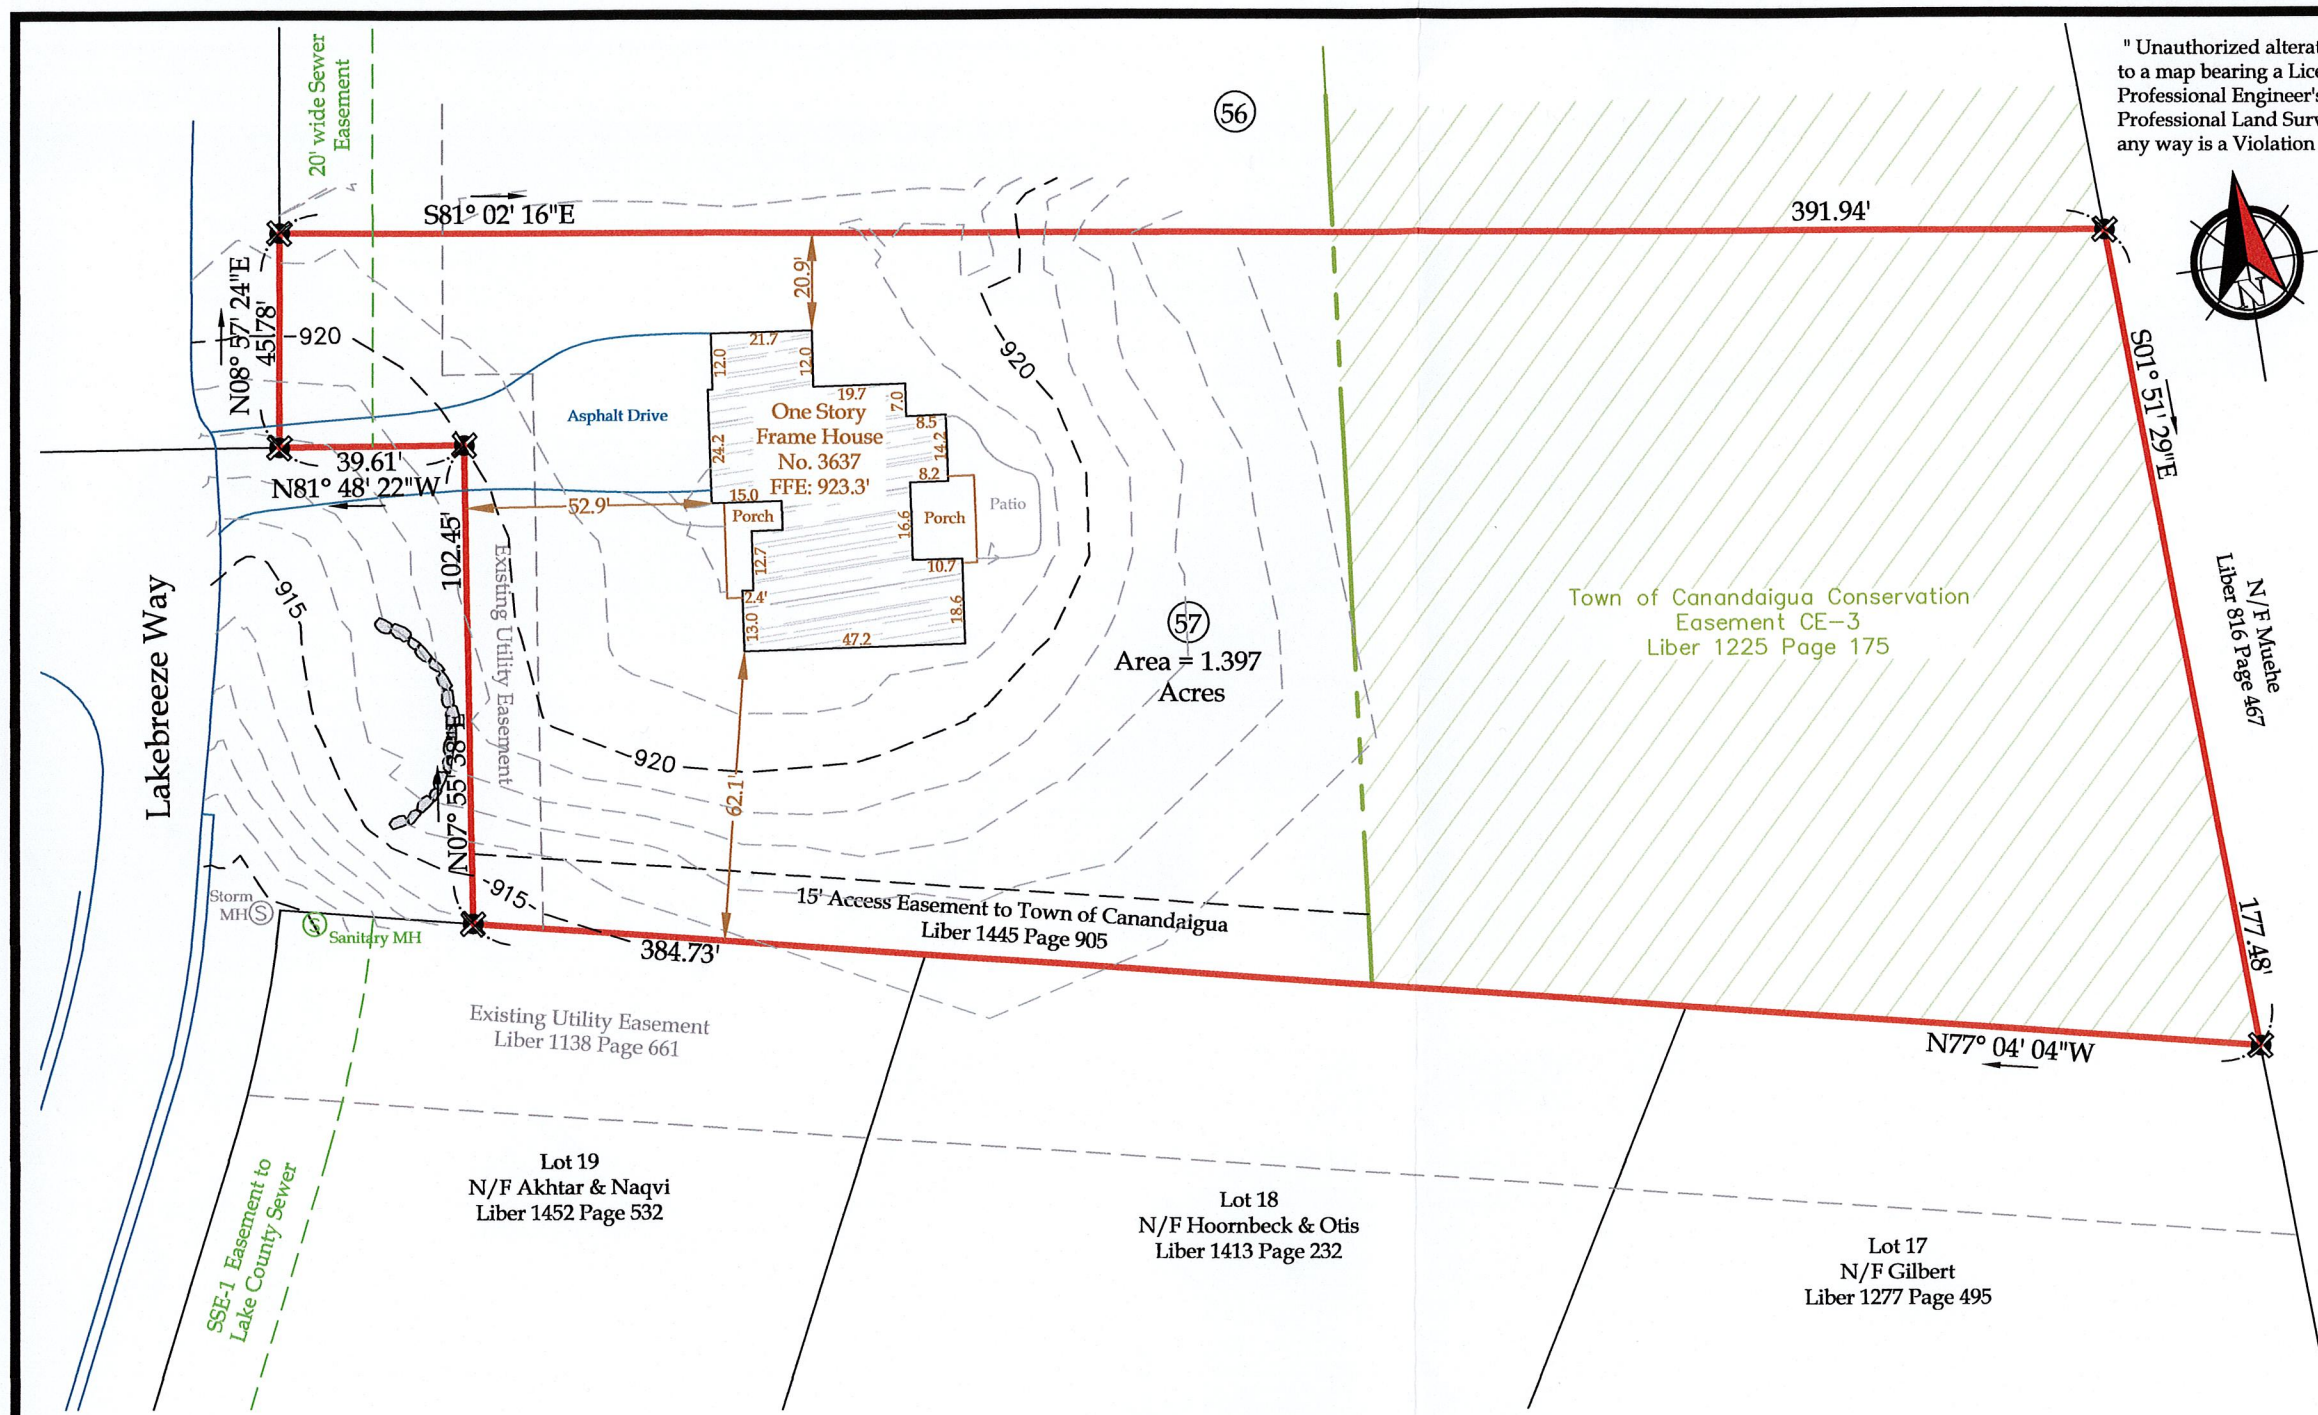

- Legend**
- ✕ iron pin or pipe found
 - ✕ iron pin set
 - utility pole
 - ohw — utility lines
 - r.o.w. line
 - property line
 - centerline

As-Built Survey prepared for:

Gregory & Denise Kalbach
3637 Lakebreeze Way
Town of Canandaigua
County of Ontario State of New York

