

ADMAR
SUPPLY COMPANY INC.
Construction Equipment & Supplies
RENTAL • SALES • SERVICE • PARTS

2390






ADMAR
SUPPLY COMPANY INC.
Construction Equipment & Supplies
RENTAL • SALES • SERVICE • PARTS

2390



Item	Inv	Part #	Part Description	Description	Height	Width	Qty
1	1.8	ALA-012511-6063T5	AL.ANGLE 1/8 X 1 X 1 X 21'-0"	ANGLES - CORNER SUPPORTS		5 1/8"	4
2	5.0	ALA-012521-6063T5	AL.ANGLE 1/8 X 2 X 1 X 21'-0"	ANGLE - REMOVABLE SIDE RETAINER		4'-0"	1
3	0.0	ALA-012521-6063T5	AL.ANGLE 1/8 X 2 X 1 X 21'-0"	ANGLE - LIFTING - SUPPORTS TOP		5 1/8"	2
4	2.0	AL-AS28059	AL. EXT AS28059 6063T5 24'-0"	POWER SUPPLY RACEWAY		2'-0"	1
5	24.4	ALCOL-03248-WBS	AL.COIL .040 X 48" WIDE	BACK COVER	3'-11 3/4"	6'-0 1/2"	1
6	24.4	AL-X1	AL.EXT #X1 6" WIDE DOUBLE 24'-3"	FILLER - SIDES		4'-0"	2
7	0.0	AL-X1	AL.EXT #X1 6" WIDE DOUBLE 24'-3"	FILLER -TOP & BOTTOM		6'-0 5/8"	2
8	2.0	HD-013	BOLT 1/2-13X2" HEX HEAD Z.P. GRD.5	1/2" DIA HEX BOLT			2
9	15.0	LED067	LED GEPM-71-1 TETRA POWER MAX 7100K	LED MODULE - GE LED - TETRA POWER MAX			15
10	1.0	PS-1260U	POWER SUPPLY GE 12-60U-NA	GE POWER SUPPLY			1
11	1.0	SC-007	JUMPER LED 144" FEMALE TO STRIPPED	12' SUPPLY WIRE			1
12	5.0	SC-009	JUMPER LED 12" FEMALE TO FEMALE RED	12" JUMPER WIRE			1
13	0.3	SUB-106	COVER BALLAST RACEWAY EXTR. 96"LG.	COVER - POWER SUPPLY RACEWAY		2'-0"	1
14	1.0	SUB113	KUBOTA 4X6' ACRYSTEEL MOLDED PAN	FACE - TRIM SIZE: 3'-11 5/8" x 6'-0 1/4" (NO H.S.)	3'-11 5/8"	6'-0 1/4"	1
15	1.0	SUB114	KUBOTA 21X29" MOLDED MUSTANG LOGO	MUSTANG - FACE			1
16	2.0	SUB146	RACEWAY (WING CH) FORMED 120"LG	WING CHANNEL - LED MOUNTING		6'-0 1/4"	3
17	0.1	VFSCO-48RL-363022BLK	SCOTCHCAL 48" WIDE 3630-22	SCOTCHCAL - TRADE MARK			1
18	33.0	VFSCO-48RL-363044OR	SCOTCHCAL 48" WIDE 3630-44 ORANGE	SCOTCHCAL - FACE			1
19	5.0	VFSCO-48RL-363570WH	SCOTCHCAL 48"WIDE 3635-70 WHITE	SCOTCHCAL - DIFFUSER			1
20	1.0	Z-SR-CC4	CONNECTOR "L16-3/8" STRAIGHT	WIRE CABLE CONNECTOR			1
21	1.0	Z-SR-CH17	TOGGLE SWITCH 120V	SWITCH - 120V			1
22	4.0	Z-SR-L-2DIAAL	LOUVRE 2" DIAMETER ALUMINUM	2" LOUVRES			4
23	2.0	Z-SRNUT-0513FWN-CS	NUT WELD 1/2-13 FLOATING	WELD NUTS			2

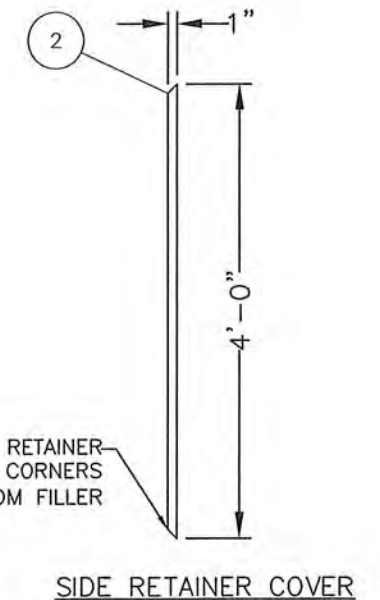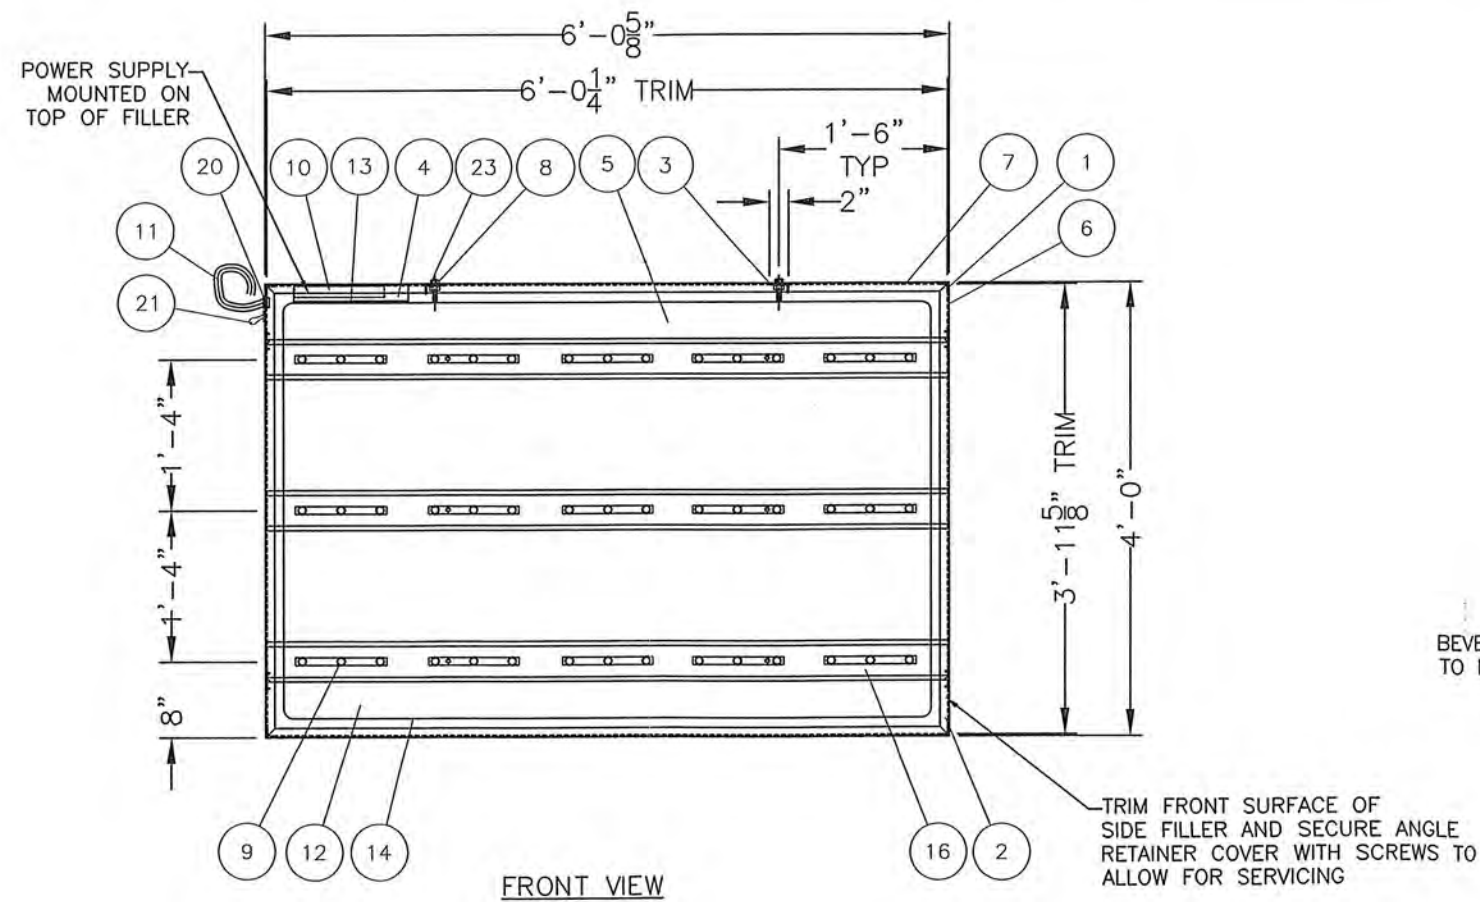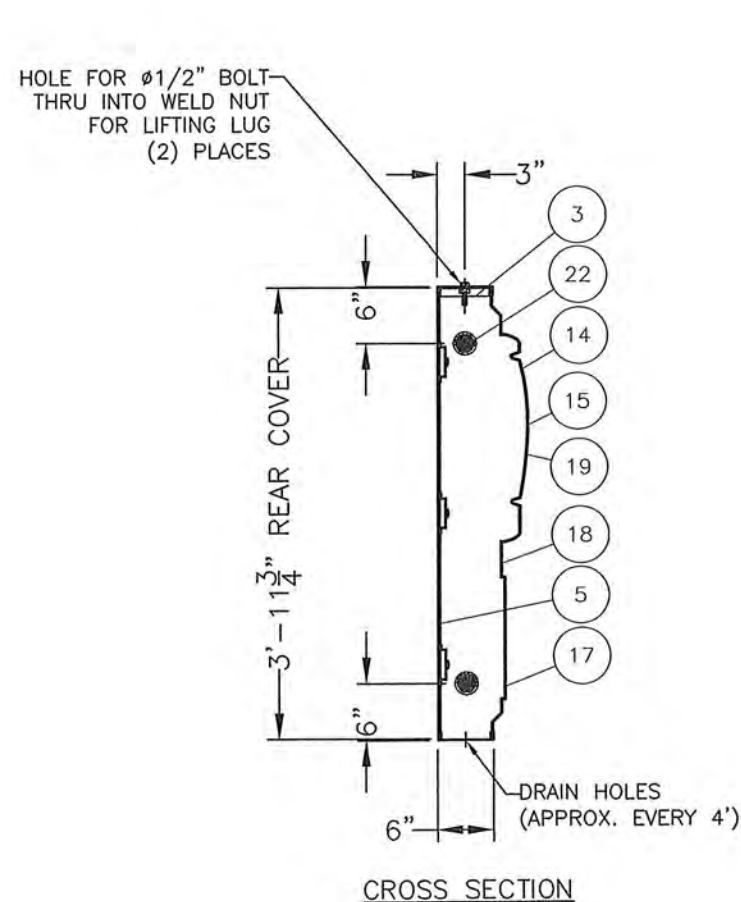

NOTE :

- ALL WELDING PROCEDURES TO BE IN ACCORDANCE WITH CWB.
- ALL ELECTRICAL COMPONENTS TO BE UL APPROVED.

SHIPPING LIST :

SEE W.O. FOR QUANTITIES, SHIPPING LIST, & MNTG. HARDWARE

TOUCH UP PAINT

FINISH: SEE ART. DRAWING

SEE ART DRAWING

TOTAL WEIGHT :

95 LBS

ELECTRICAL:

(15)LED-GE TETRA POWER MAX 7100K
(1)POWER SUPPLY-PSA-1260U GE

TOTAL LOAD : 0.61 AMPS.
USE ONE 15A/120V CIRCUIT/S.

36/15	3	AS BUILT	AUG. 21/15	ML
ECN #	REV.	DESCRIPTION	DATE	SALES
				ENG.
				APPROVED

86 PLANT FARM BLVD, BRANTFORD, ON. N3S 7W3 TEL (519) 756-1089 FAX (519) 756-1595			
CUSTOMER		KUBOTA - VARIOUS LOCATIONS	
JOB TITLE		4'-0" x 6'-0 5/8"- S/F FACIA SIGN - LED ILLUM.	
SIGNATURE	DATE	W/O No.	Compu Dwg.No.
DV	NOV 4/13	MSTR-KUB-F-050340	ENG\KUB\2013\MSTR 2013
Review/Ver.		Drawing No.	
Sales		MSTR-KUB-F-050340	3
Validation		Scale	N.T.S.
		Sheet	1 of 1