Deed Reference:
Robert W. Swadling to Roger L. & Kathleen A. Schutt by Deed filed May 18, 2020 in Liber 1450 of Deeds at Page 530.
Abstract Reference:
This Survey is subject to any facts an updated Abstract of Title may reveal.
Map Reference:
Subdivision Plat Prepared for Roger L. & Kathleen Schutt by Venezia & Associates being Job No. 19195 filed in the Ontario County Clerks Office as Map No. 37018.

" Unauthorized alteration or addition to a map bearing a Licensed Professional Engineer's or Professional Land Surveyor's seal in any way is a Violation of Section 7209"

" Copyright 2021" Venezia & Associates. All rights reserved unauthorized duplication is a violation of all applicable laws"

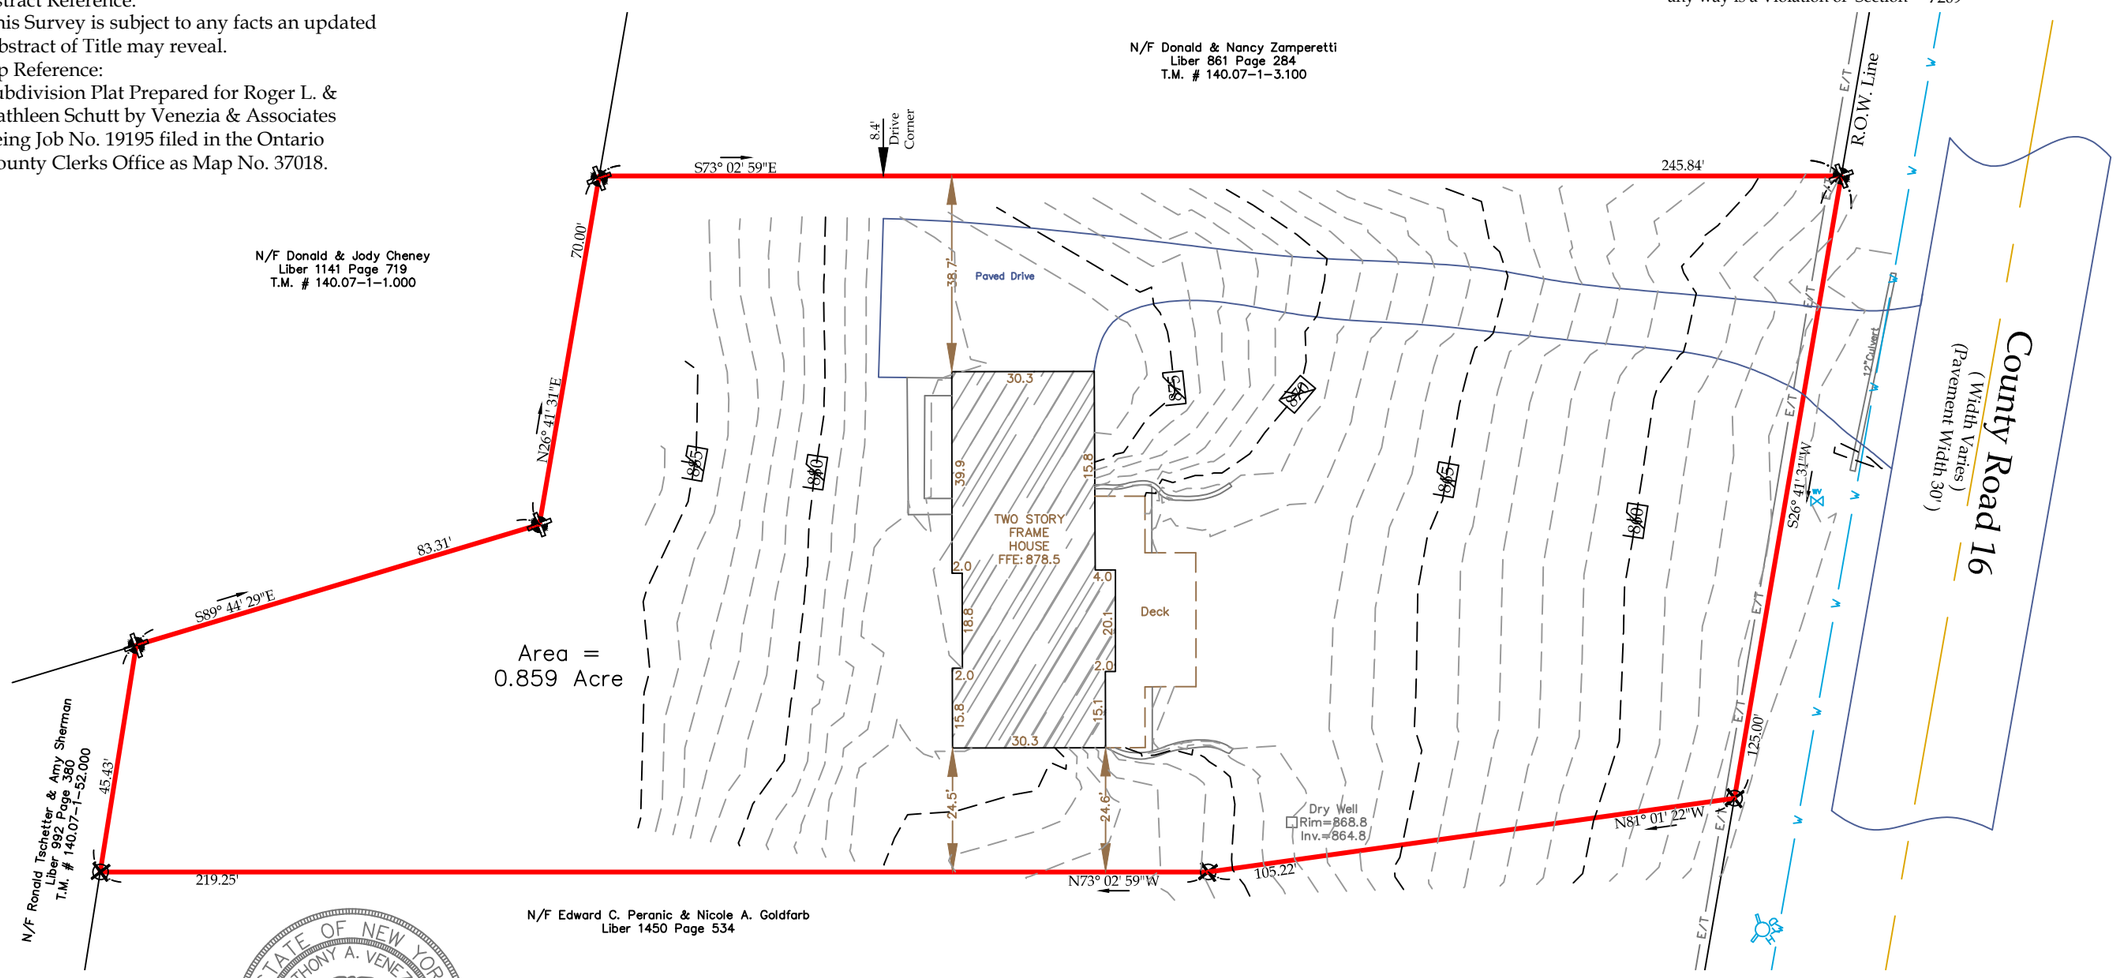

Anthony A. Venezia
signed _____
License No. 050864

STATE OF NEW YORK
ANTHONY A. VENEZIA
NO. 050864
Licensed Land Surveyor

This is to certify that I am a Licensed Land Surveyor and that this plan was completed on 8/18/2021 from notes of an instrument survey performed on 8/17/2021.

Legend
- iron pin or pipe found
- iron pin set
- utility pole
- E/T — utility lines
- r.o.w. line
- property line
- centerline

As-Built Survey Prepared for:

Roger L. & Kathleen A. Schutt

Town of Canandaigua
4520 County Road 16
County of Ontario
State of New York

T.M. Parcel # 140.07-1-5.110
Scale 1" = 30'
File 19195ASB

VENEZIA
LAND SURVEYORS AND CIVIL ENGINEERS

www.veneziasurvey.com 5120 Laura Lane Canandaigua New York, 14424 (585)396-3267 Fax (585)396-0131 E-mail rocco@veneziasurvey.com